Attachment # 2
Page 1 of 1

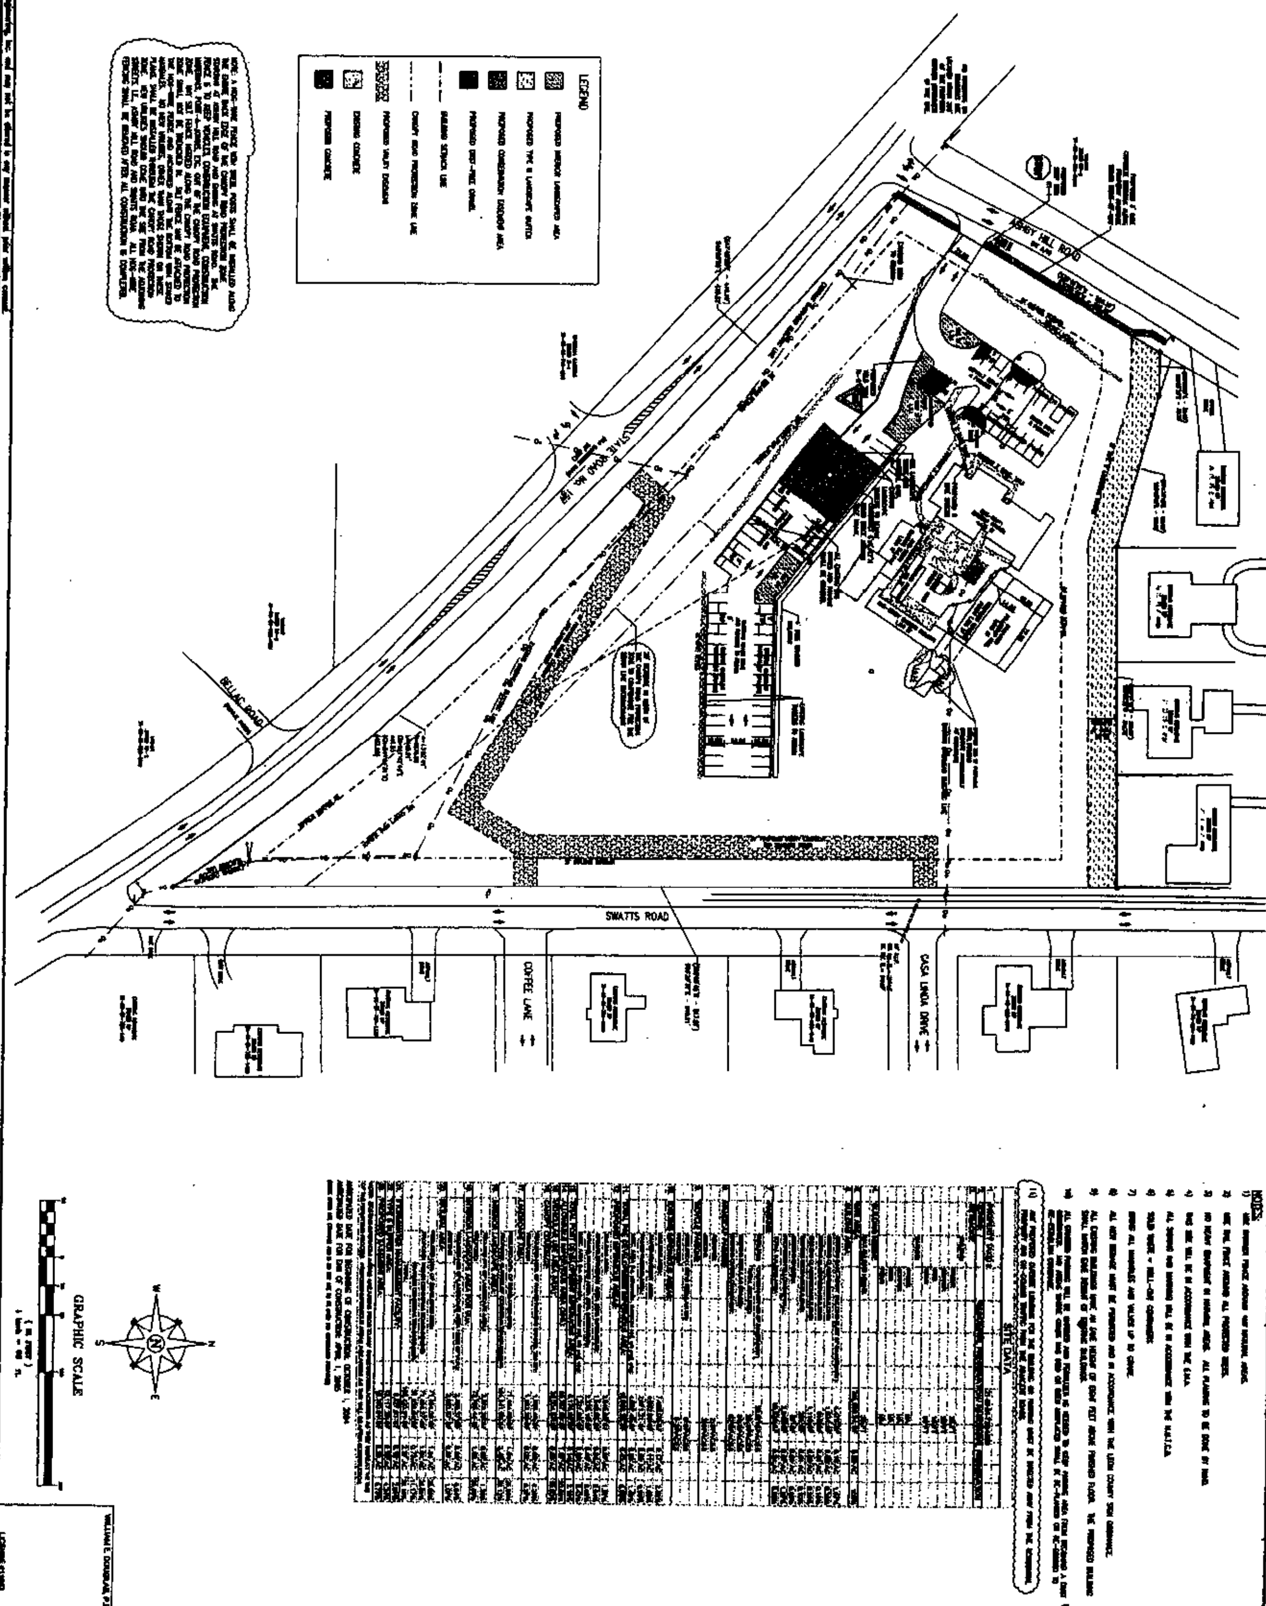

WILLIAM E. DOUGLAS, P.E.

PROJECT: St. Francis of Assisi Episcopal Church Addition

TITLE: Site Plan — **SCALE:** 1" = 50'

		Revised by:	Date:	Description:
File Name:	2829 master.dwg			
Designed:	KDH	KDH	MAR 16, 2004	REVISED PER TECHNICAL REVIEW COMMENTS
Drawn:	KDH	KDH	JUL 7, 2004	REVISED PER ENVIRONMENTAL IMPACT ANALYSIS REVIEW COMMENTS
Checked:	WED	KDH	AUG 3, 2004	REVISED PER LEON COUNTY GROWTH MANAGEMENT REVIEW COMMENTS
Date:	10/17/03	KDH	AUG 16, 2004	REVISED PER LEON COUNTY DRC REVIEW COMMENTS

Sheet 2 of 4

No. 02D-829

DEC Engineering, Inc.
Civil Engineering
William E. Douglas, P.E., President
2467 Centerville Road Tallahassee, Florida 32308
Phone: (850) 385-6288 Fax: (850) 385-7586
Email: dec@nettally.com State Certification #4244